




kinslow, keith & todd, inc.
 architecture | interiors
 tel 918.744.4270
 fax 918.744.7849
 2021 south lewis suite 150
 tulsa, oklahoma 74104
 www.kktarchitects.com
 info@kktarchitects.com

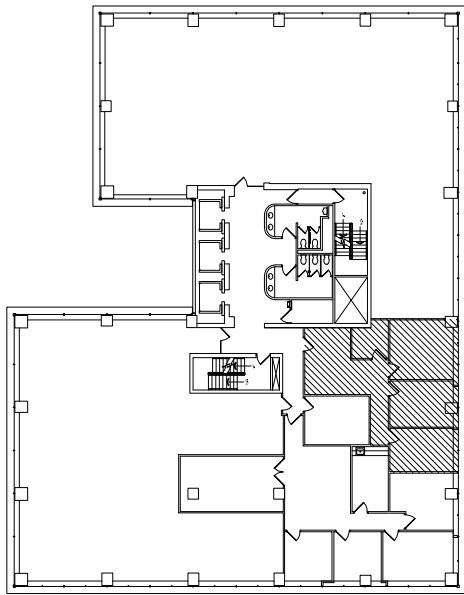


KEY PLAN

SCALE: N.T.S.



NORTH

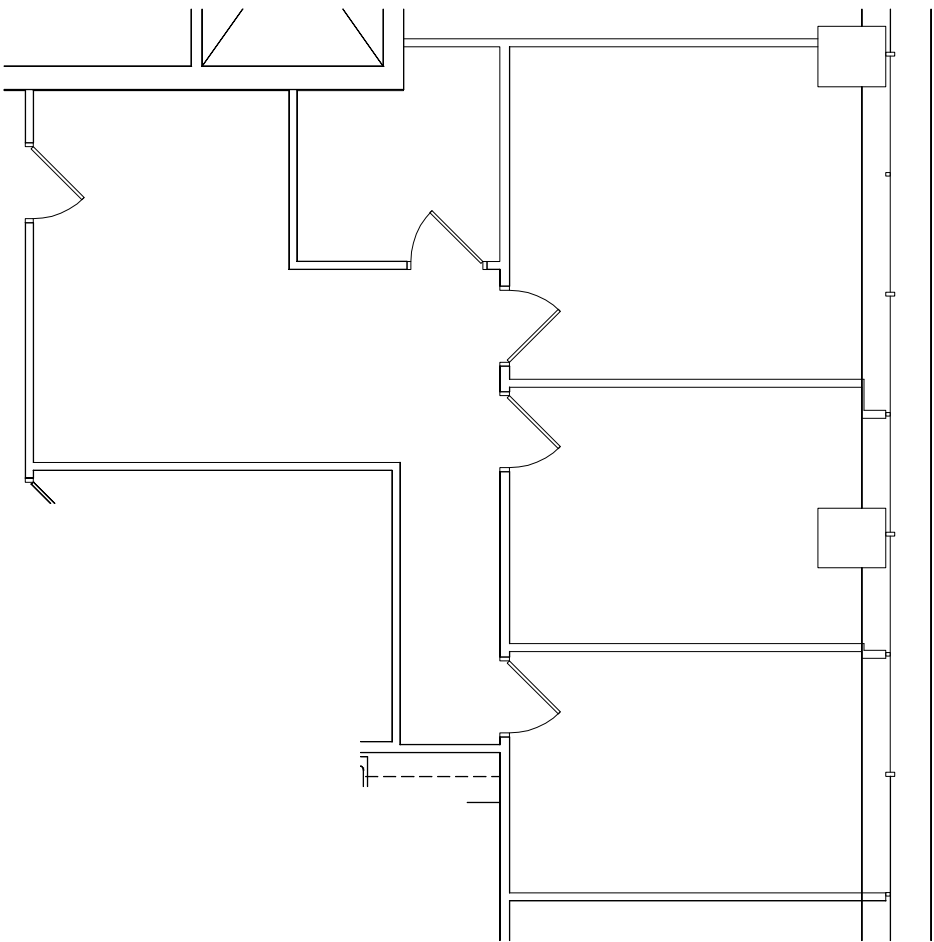

SUITE 202

PARK
TOWER
2ND
FLOOR

CASE
&
ASSOCIATES

SUITE 202
 941.32 USF
 1082.52 RSF

A FLOOR PLAN

SCALE: 1/8" = 1'-0"



NORTH

SCALE	1/8" = 1'-0"
FILE NAME	P102AS
MANAGER	BAR
DRAWN BY	BAR
DATE	04-25-06

AS-BUILT
PLAN
AS-1