




Kinslow, Keith & Todd, Inc.
 architecture | interiors | engineering
 tel 918.744.4270
 fax 918.744.7849
 2200 south ulfca place, suite 200
 tulsa, oklahoma 74114
 www.kktarchitects.com

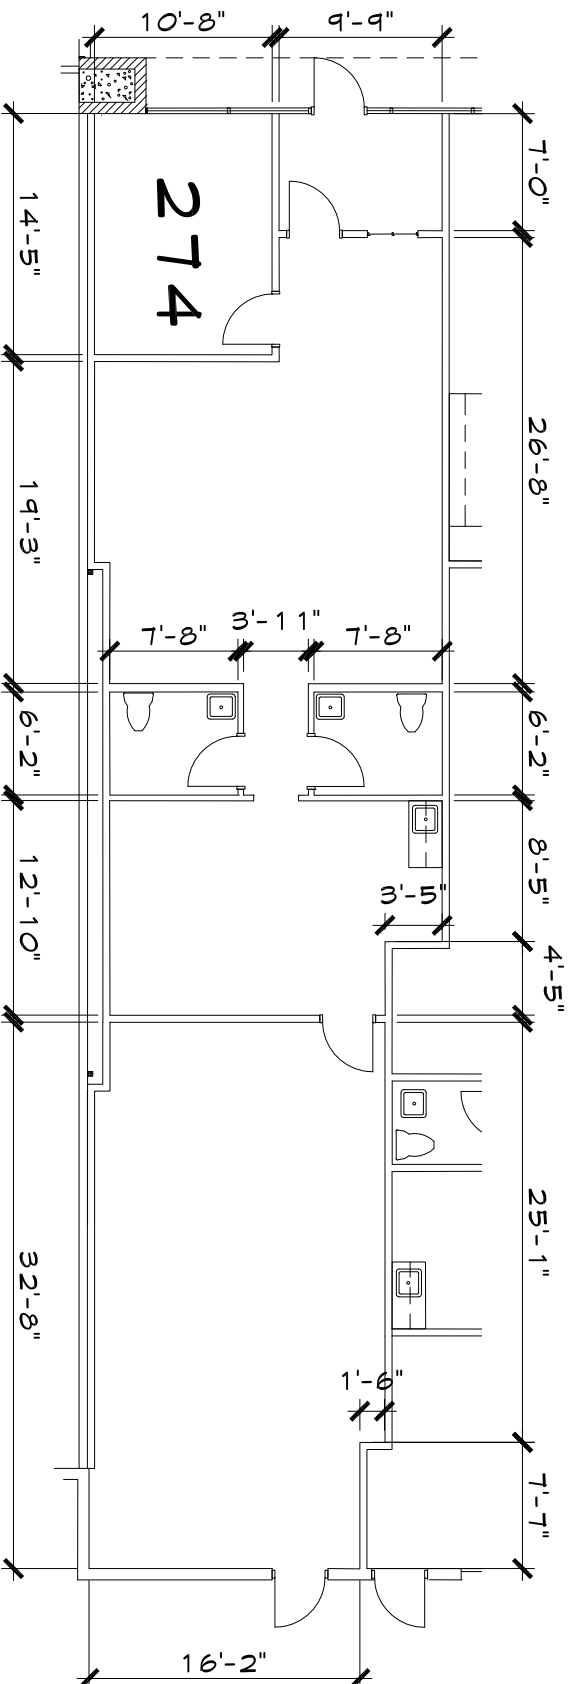

**SUITE
274**
 FREEPORT
 TRADE
 CENTER
 BUILDING 2
 CASE
 & ASSOCIATES

SCALE	N.T.S.
FILE NAME	TCB2FPAL
MANAGER	ELS
DRAWN BY	
11.19.10	

A FLOOR PLAN

SCALE: N.T.S.



SUITE 274
 VACANT
 OFFICE - 1184.76 USF
 WAREHOUSE - 602.88 USF
 TOTAL - 1787.64 USF

AS-BUILT
 PLAN

AS-1