



Kinslow, Keith & Todd, Inc.
 architecture | interiors
 tel 918.744.4270
 fax 918.744.7849
 2021 south lewis suite 150
 tulsa, oklahoma 74104
 www.kktarchitects.com
 info@kktarchitects.com


**SUITE
606**

PARK
TOWERS
6TH FLOOR

CASE &
ASSOCIATES

SCALE	1/16" = 1'-0"
FILE NAME	P106AS
MANAGER	ELS
DRAWN BY	ELS
	11.26.14

AS-BUILT
PLAN

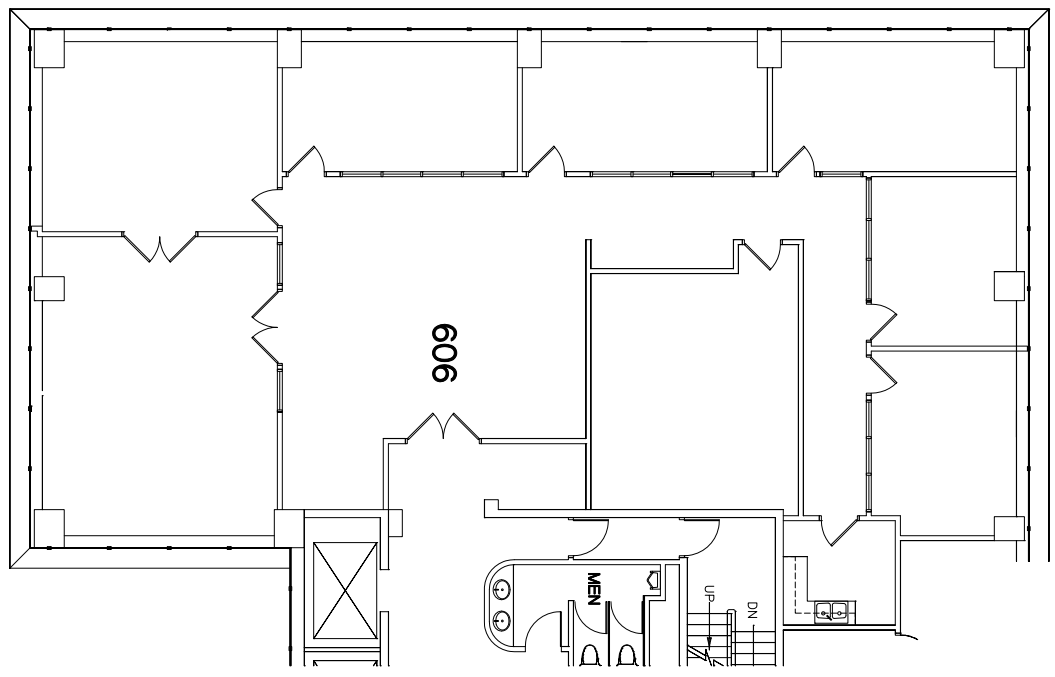

SUITE 606
CLOSED CAPITAL
3408.40 USF
3419.66 RSF

A FLOOR PLAN

SCALE: 1/16" = 1'-0"



NORTH

AS-6